


Z-BANDS (m AFF)  
walls/columns (context)  
high-level services 2.0m-soffit

L3 HIGH-LEVEL SERVICES PLAN — EAST HALF — zfloor (scan z, 2nd pct) = -1.094 m; heights AFF

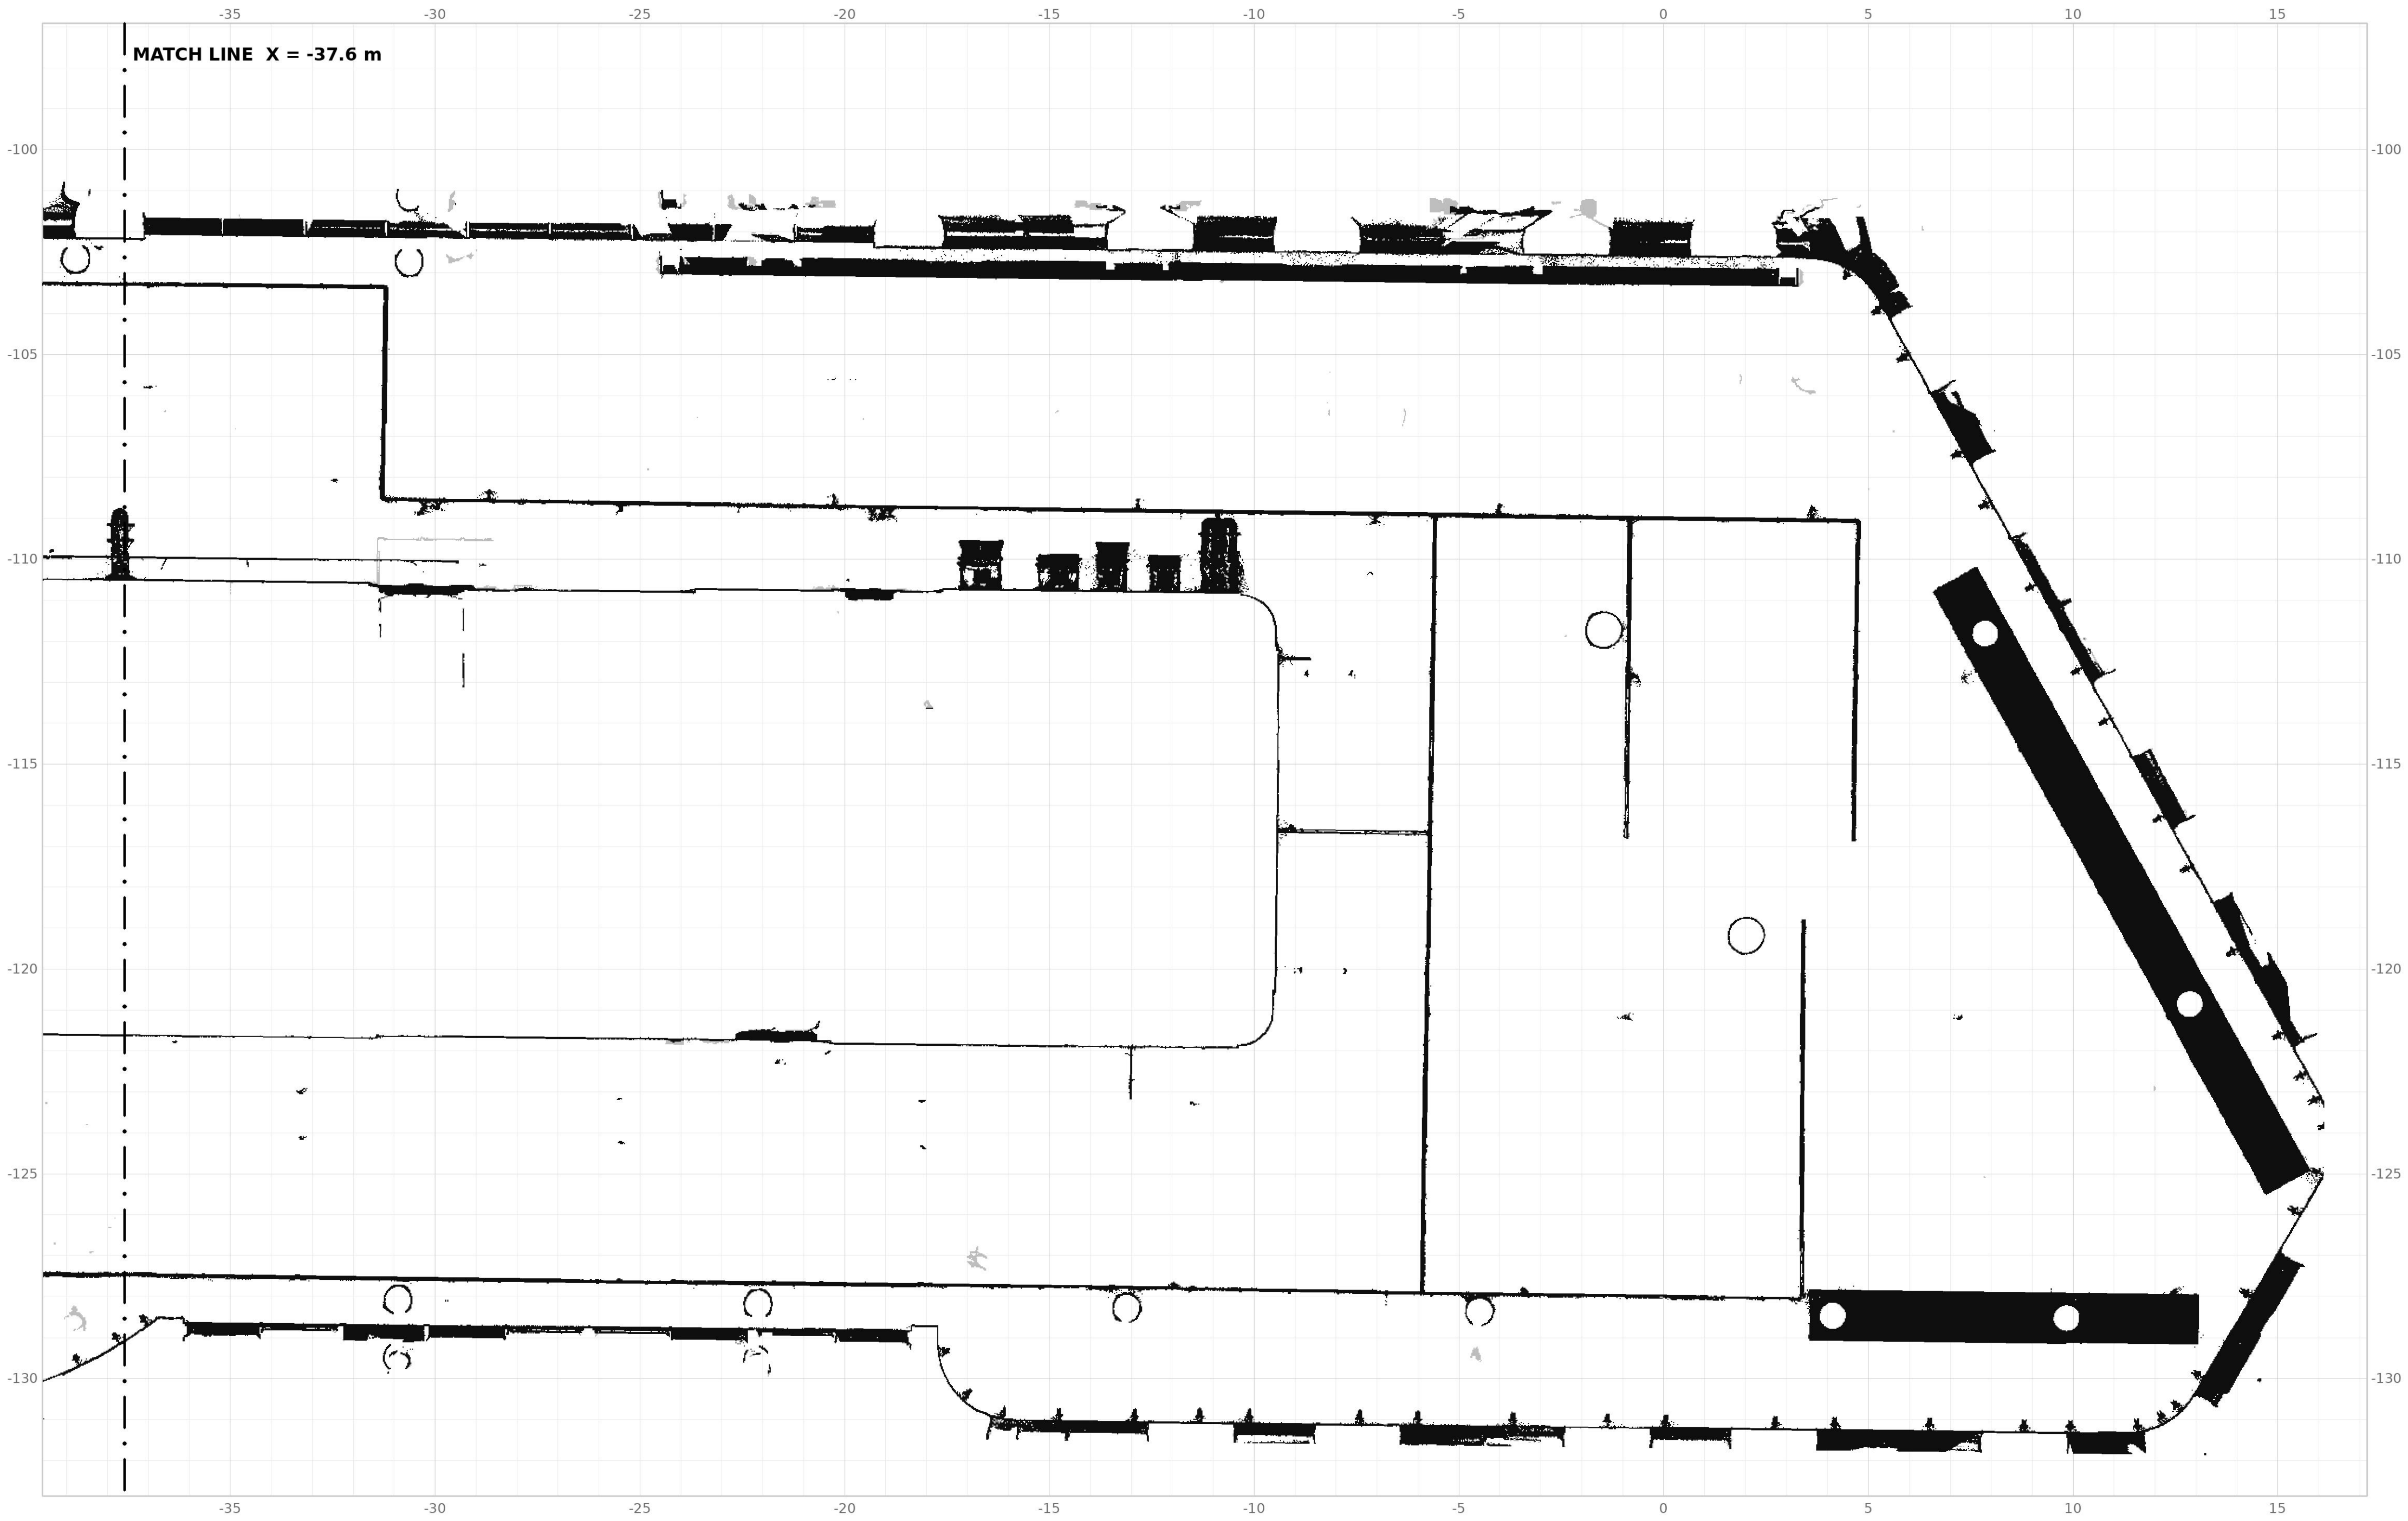

|                                                                                                                                                             |                  |
|-------------------------------------------------------------------------------------------------------------------------------------------------------------|------------------|
| ASANA FIT-OUT — AS-BUILT FROM LASER SCAN                                                                                                                    |                  |
| L3 HIGH-LEVEL SERVICES PLAN — EAST HALF                                                                                                                     |                  |
| SHEET ASA-SCAN-L03-PLAN-HL-100E                                                                                                                             | SCALE 1:100 @ A1 |
| Source: site laser scan (E57). Registered to Metec/GA project grid, residual ~60mm. Points are as-scanned; absence of points != absence of kit (occlusion). |                  |