


Z-BANDS (m AFF)

walls/columns (context)

high-level services 2.0m-soffit

L3 HIGH-LEVEL SERVICES PLAN — WEST HALF — zfloor (scan z, 2nd pct) = -1.094 m; heights AFF

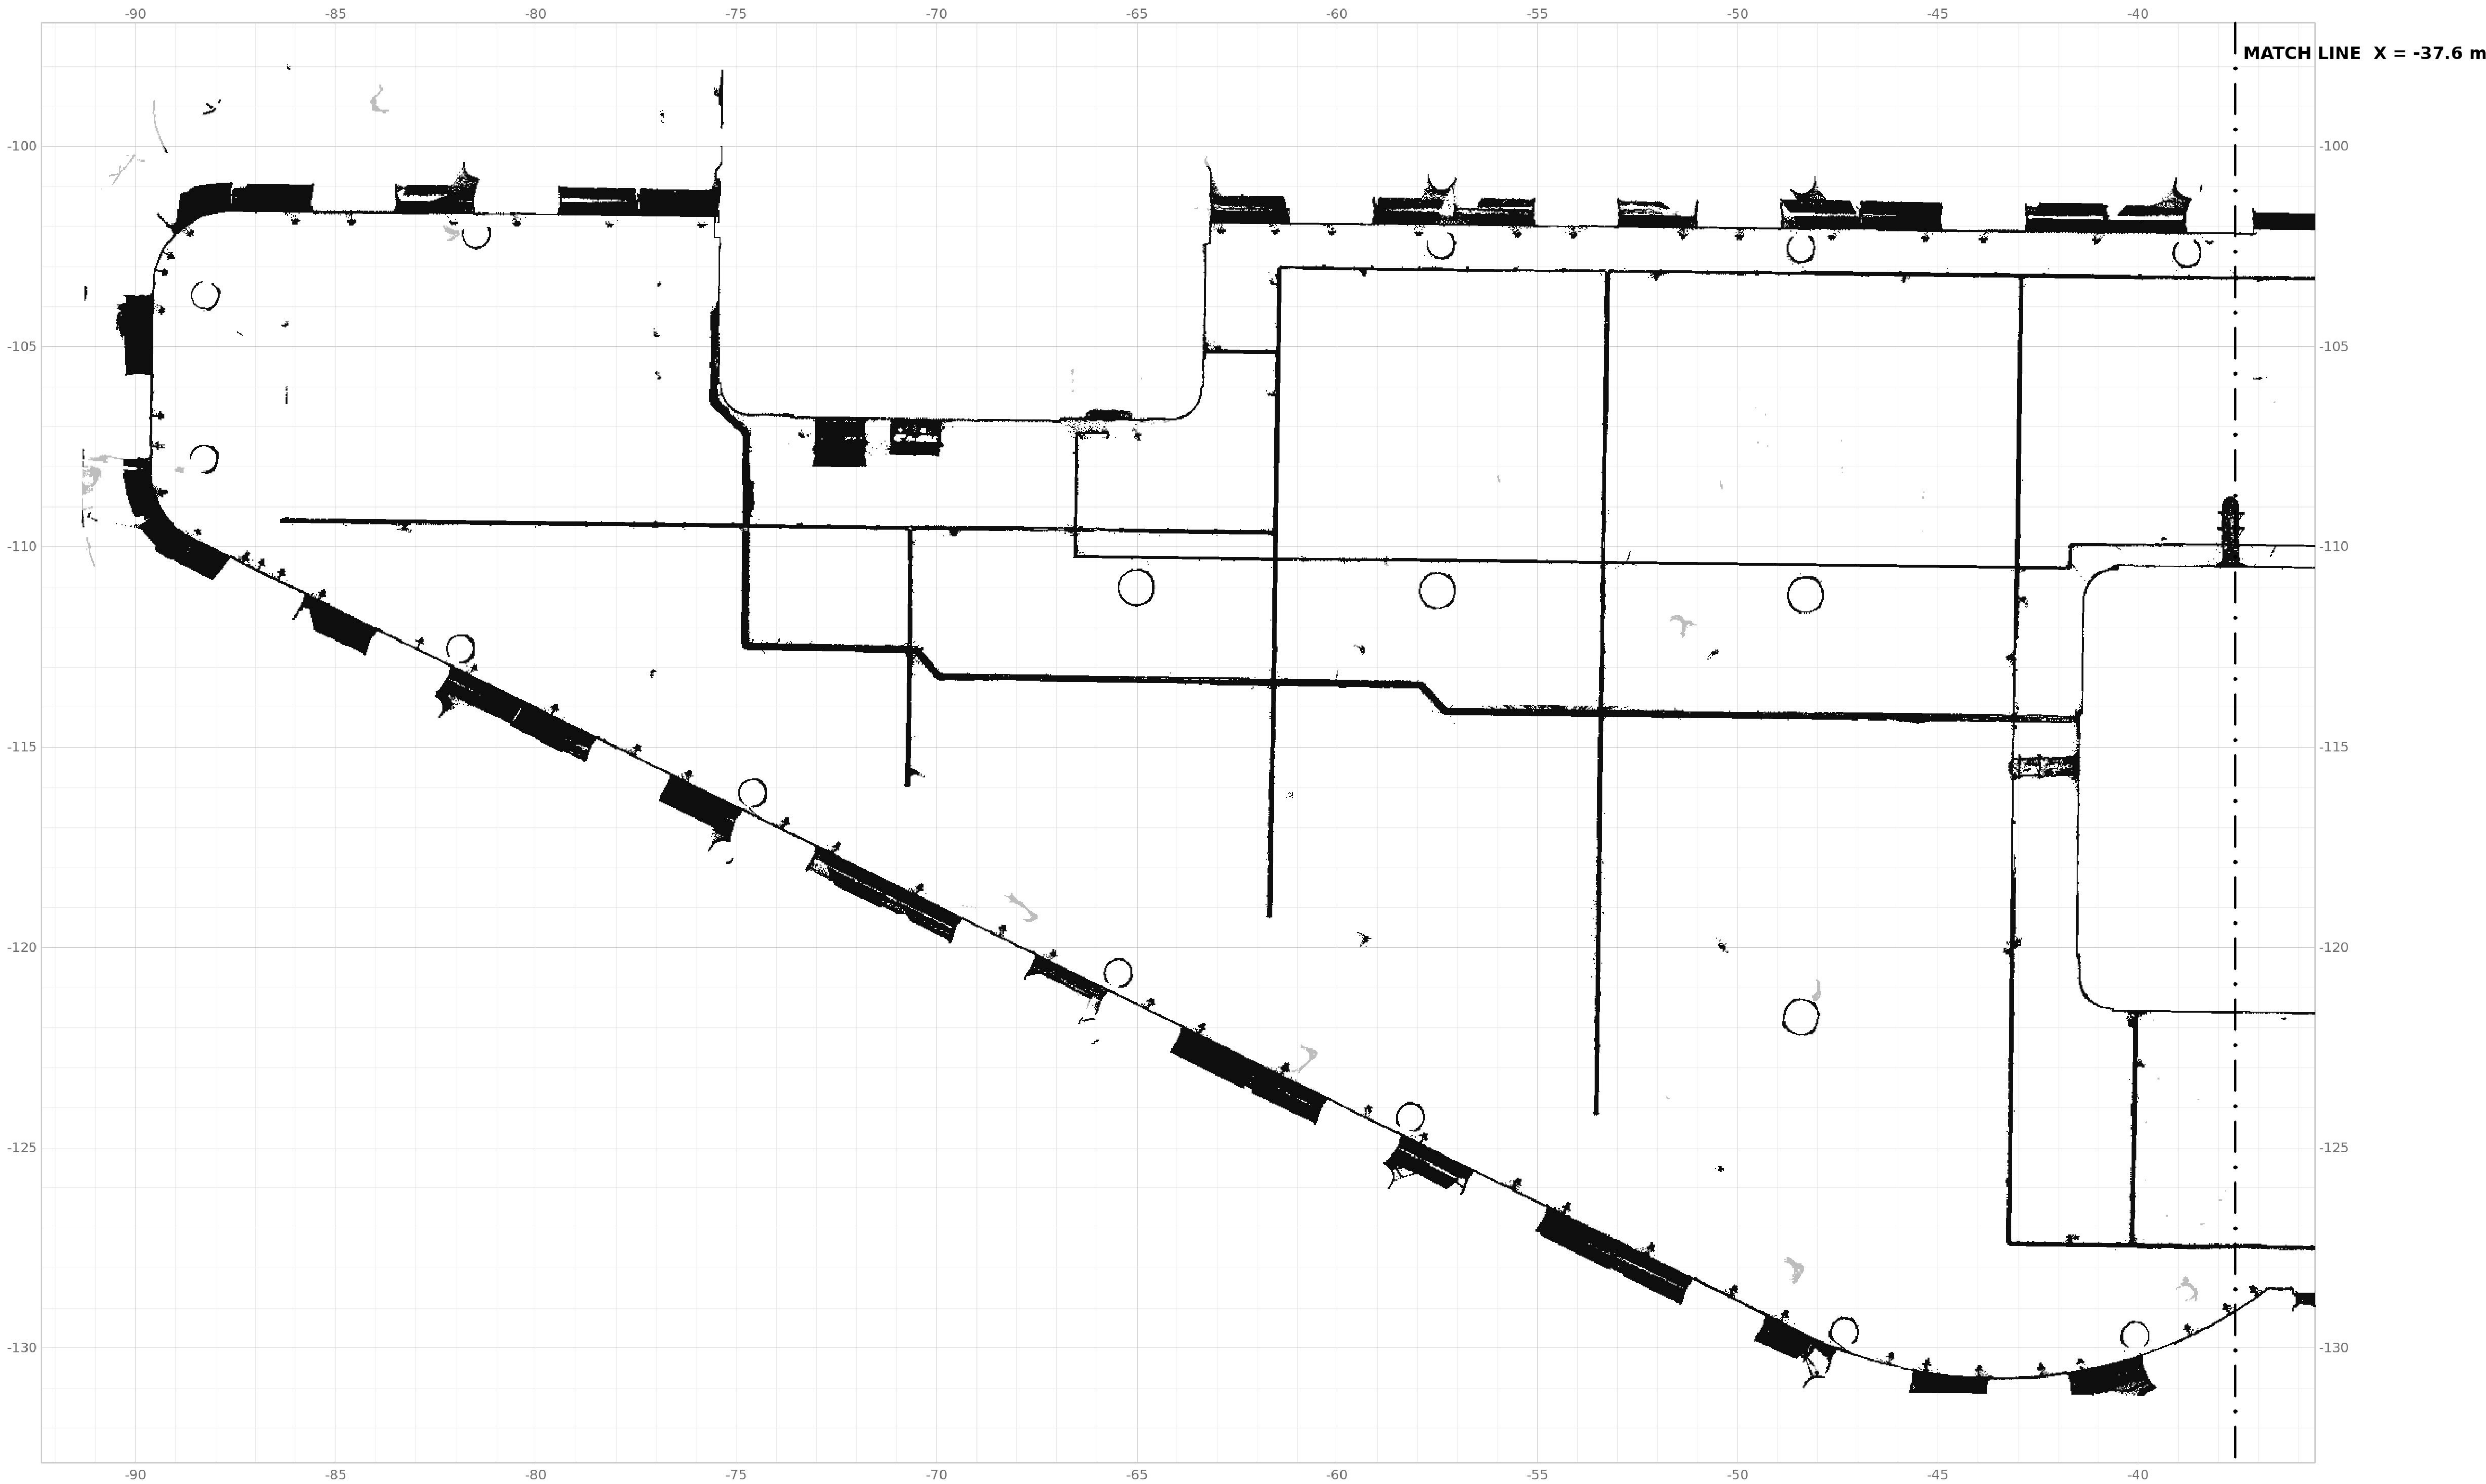

ASANA FIT-OUT — AS-BUILT FROM LASER SCAN	
L3 HIGH-LEVEL SERVICES PLAN — WEST HALF	
SHEET ASA-SCAN-L03-PLAN-HL-100W	SCALE 1:100 @ A1
Source: site laser scan (E57). Registered to Metec/GA project grid, residual ~60mm. Points are as-scanned; absence of points = absence of kit (occlusion).	