


Z-BANDS (m AFF)
■ slice @ 2.30m AFF (200mm band: 2.20-2.40m) — 175,214 pts

L3 SCAN SLICE @ 2.30m AFF — heights in m AFF; FFL datum taken from scan floor fit

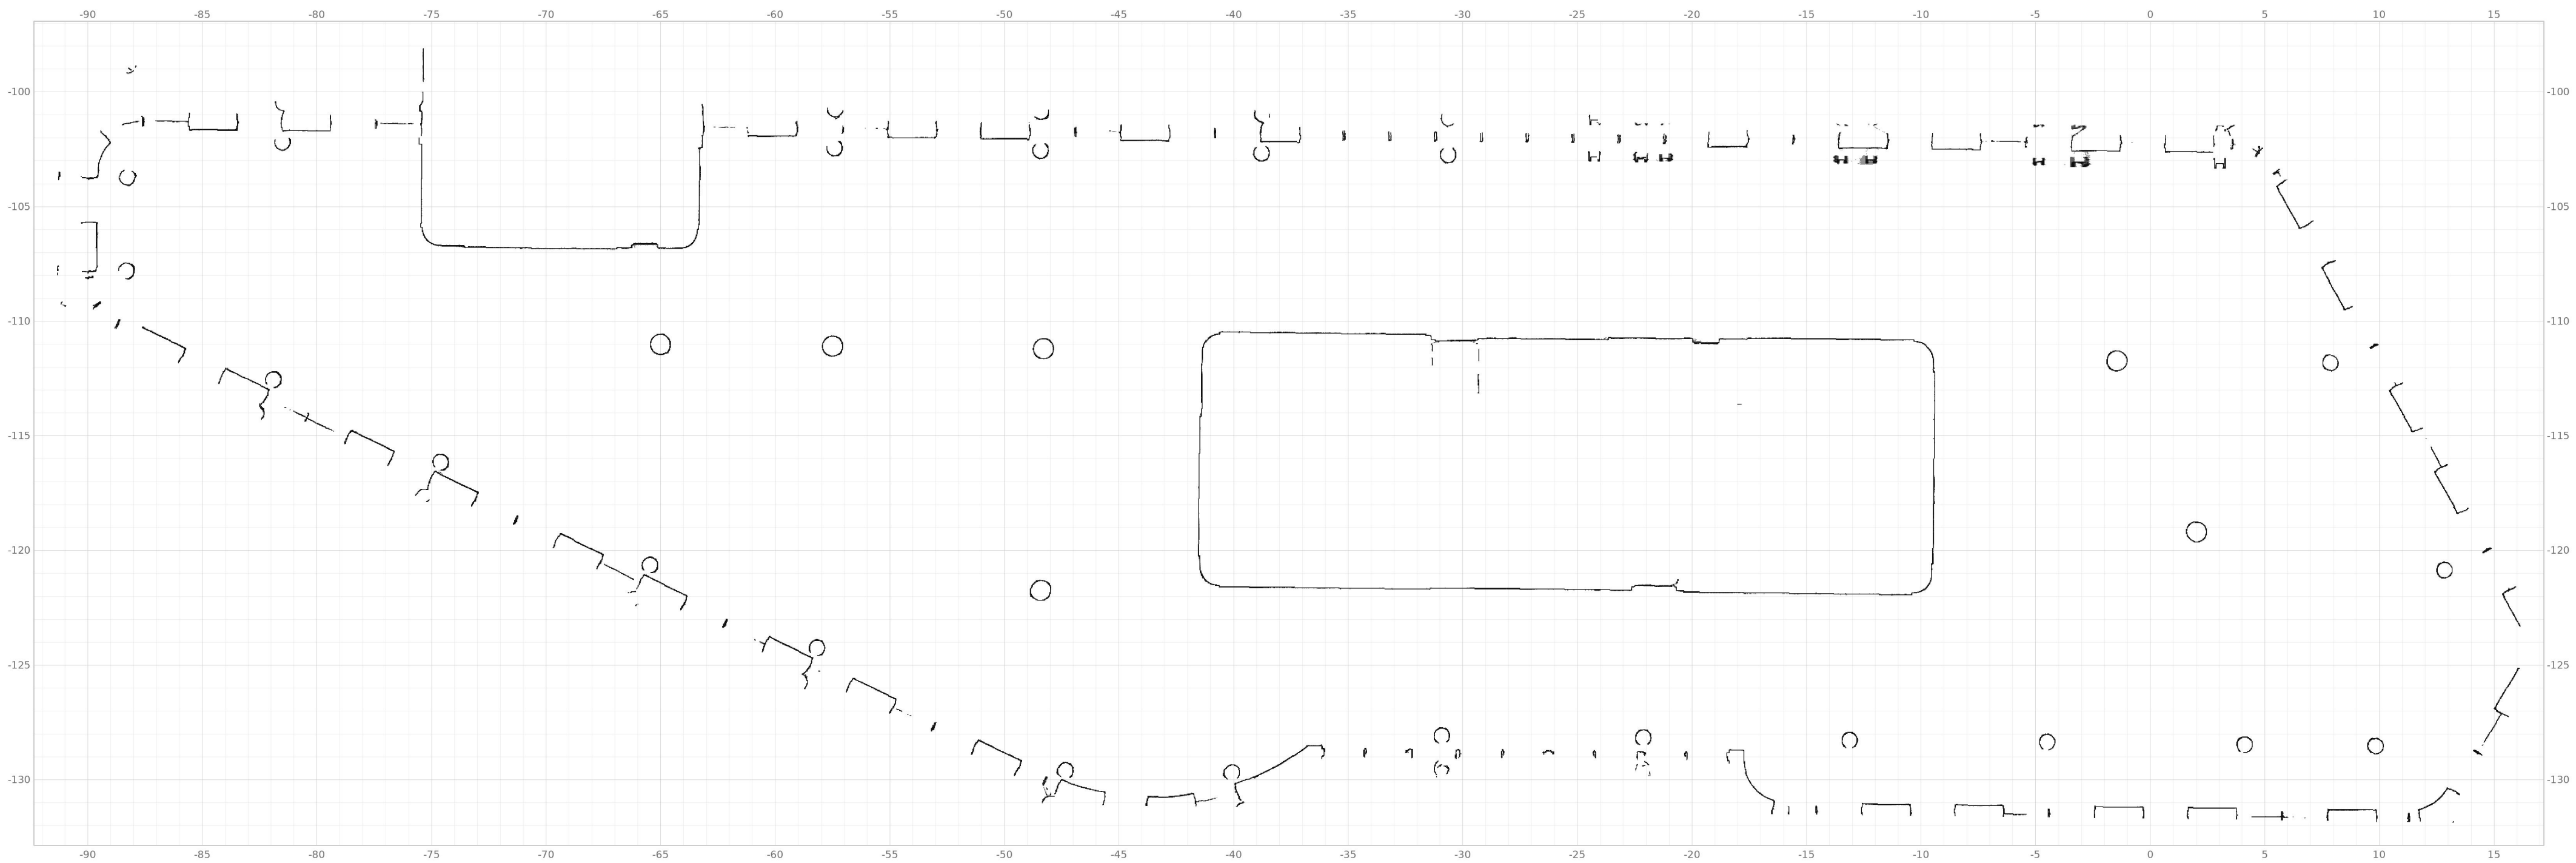

ASANA FIT-OUT — AS-BUILT FROM LASER SCAN

L3 SCAN SLICE @ 2.30m AFF

SHEET ASA-SCAN-L03-SLICE-230

SCALE 1:200 @ A1

DATE 2026-07-02

Source: site laser scan (E57). Registered to Metec/GA project grid, residual ~60mm. Points are as-scanned; absence of points != absence of kit (occlusion). Slice heights are metres above finished floor (AFF); floor datum taken from the scan floor fit (2nd-percentile z). Point display is density-shaded: darker = more scan returns per 25 mm cell.

