
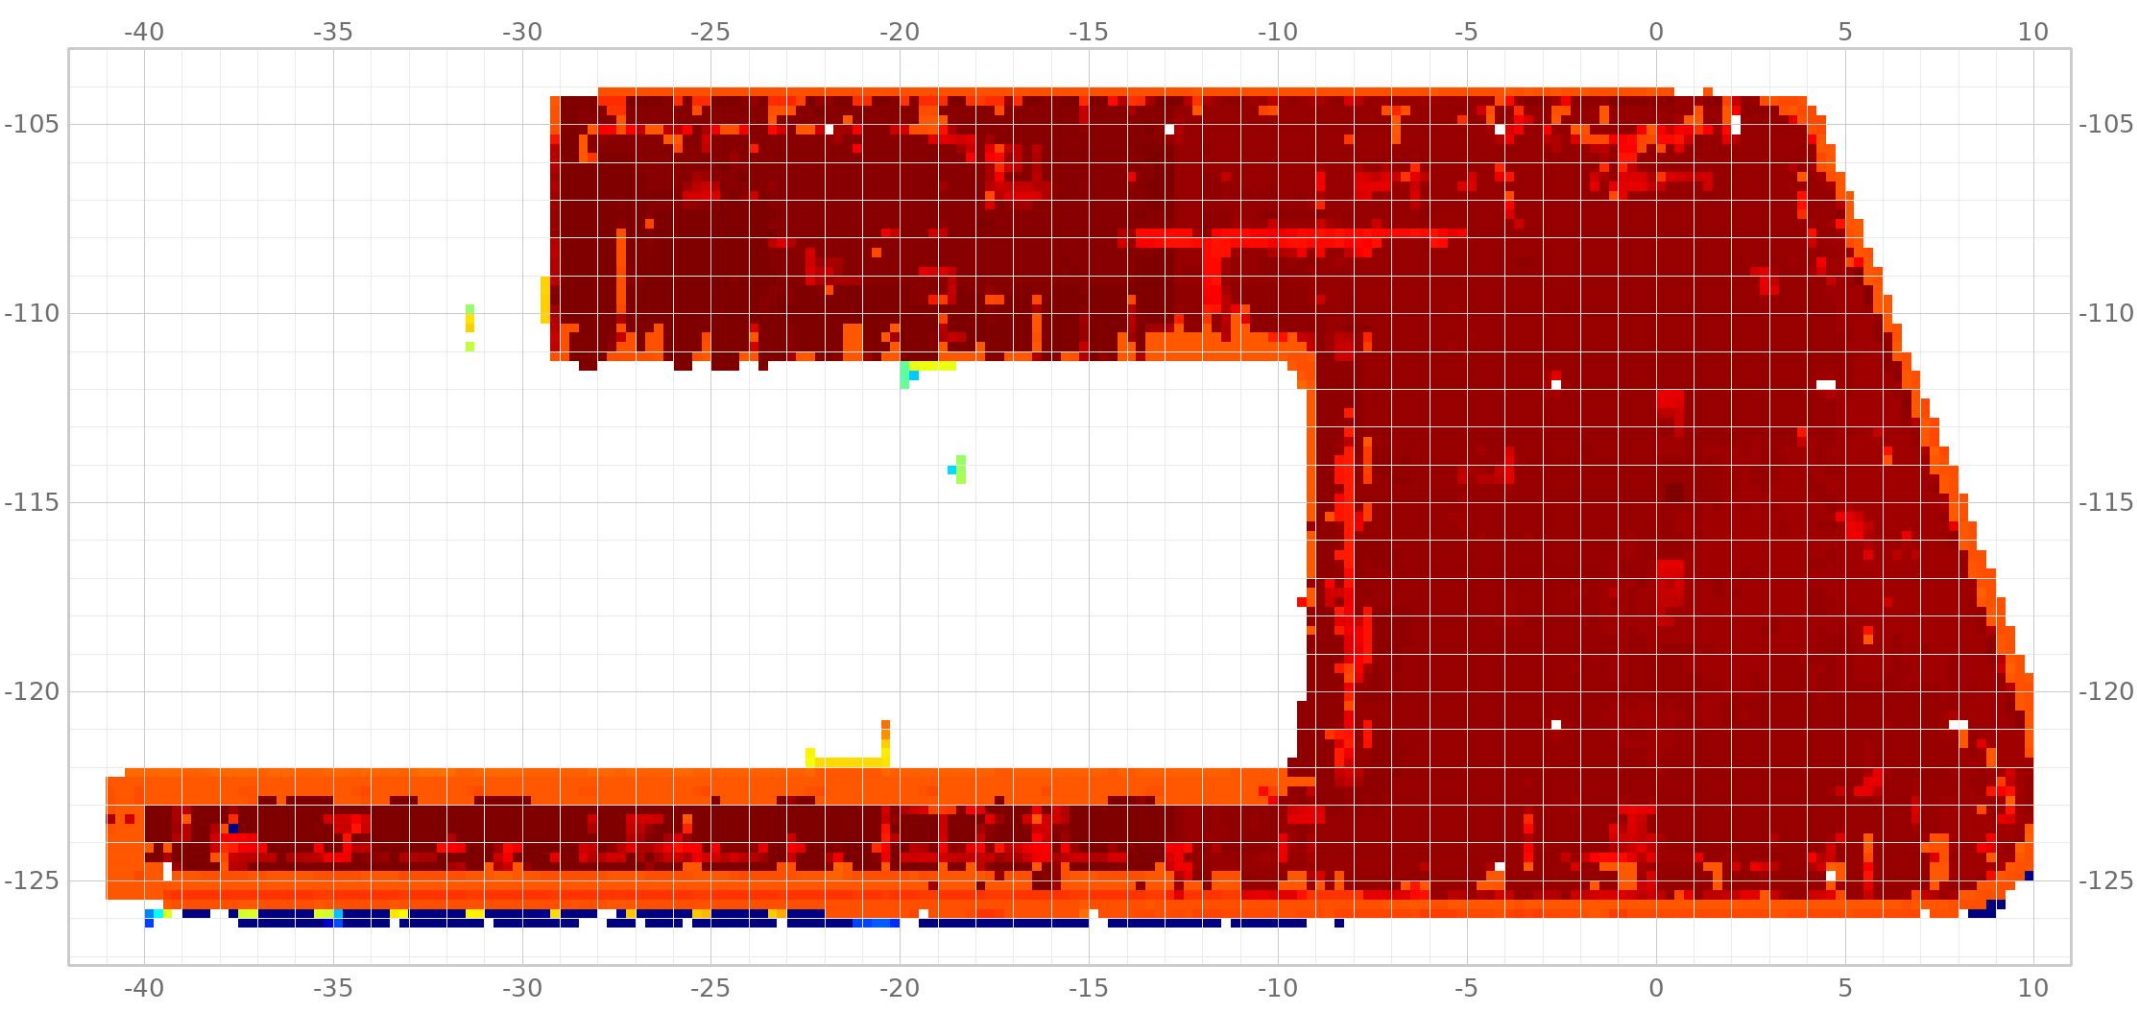


STATS
cells 250 mm, min 30 pts; 10467 valid cells
median 3475 mm p5 2825 mm p95 3550 mm
zfloor (scan z, 2nd pct) = -1.085 m
ceiling tiles removed; heights are to whatever the scan hit
— tile grid, services or soffit

L8 SOFFIT HEAT MAP

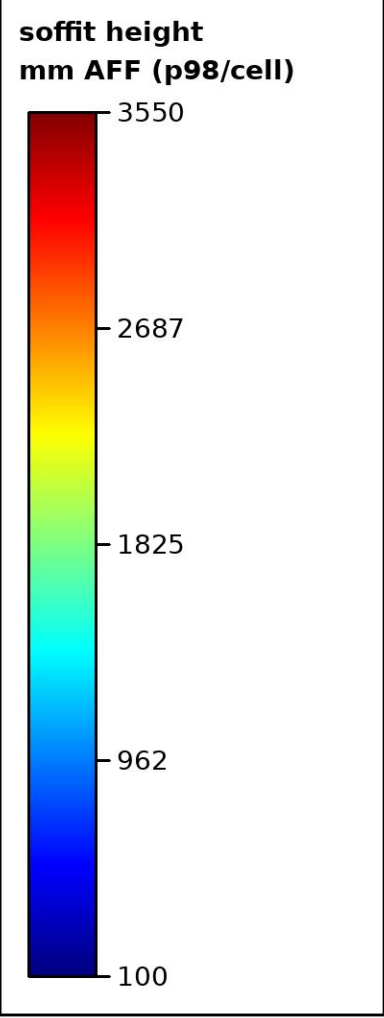

ASANA FIT-OUT — AS-BUILT FROM LASER SCAN		
L8 SOFFIT HEAT MAP		
SHEET AB-401	SCALE 1:200 @ A1	DATE 2026-07-02
Source: site laser scan (E57). Registered to Metec/GA project grid, residual ~60mm. Points are as-scanned; absence of points != absence of kit (occlusion).		